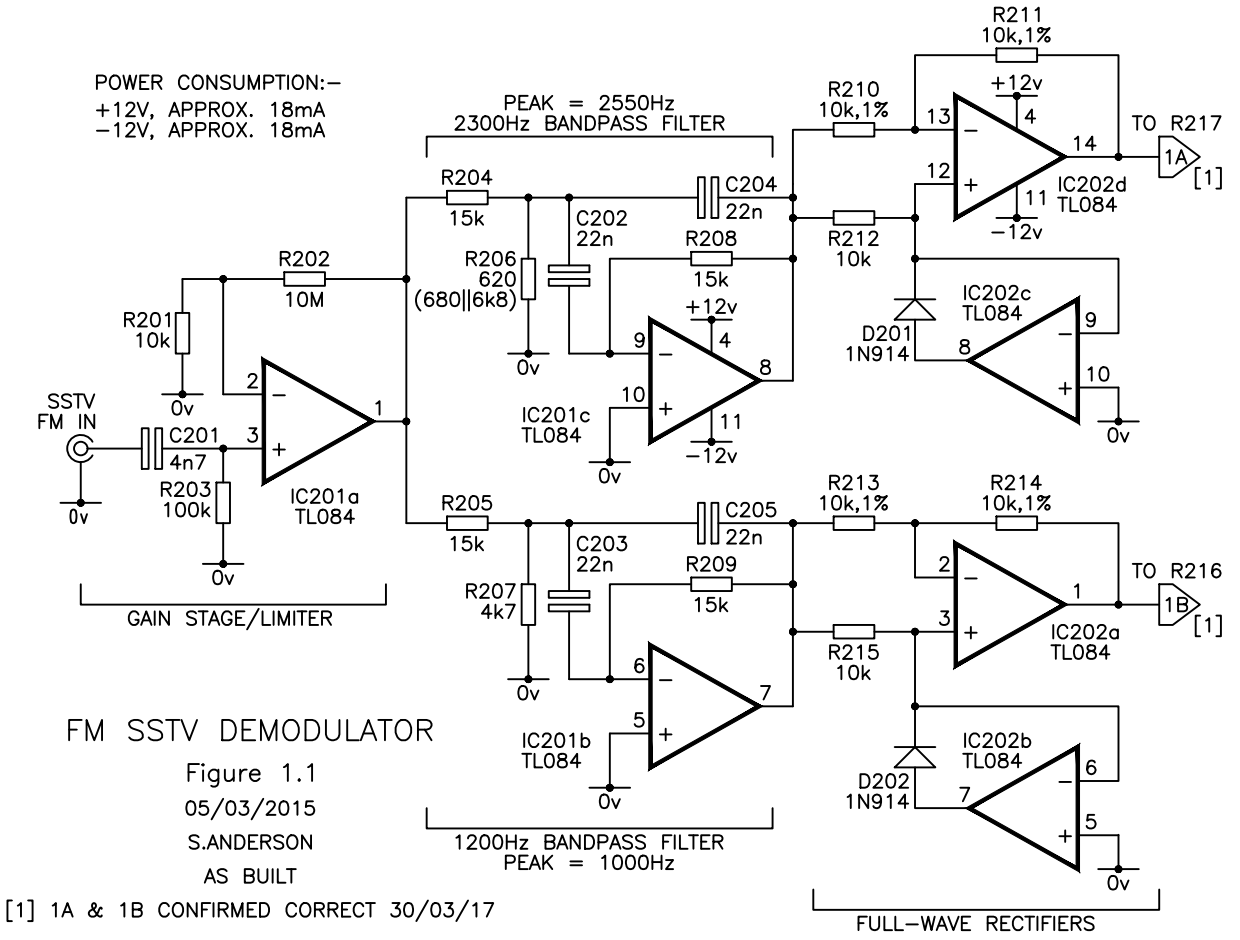


FM SSTV DEMODULATOR


Figure 1.1

05/03/2015


S.ANDERSON

AS BUILT

[1] 1A & 1B CONFIRMED CORRECT 30/03/17

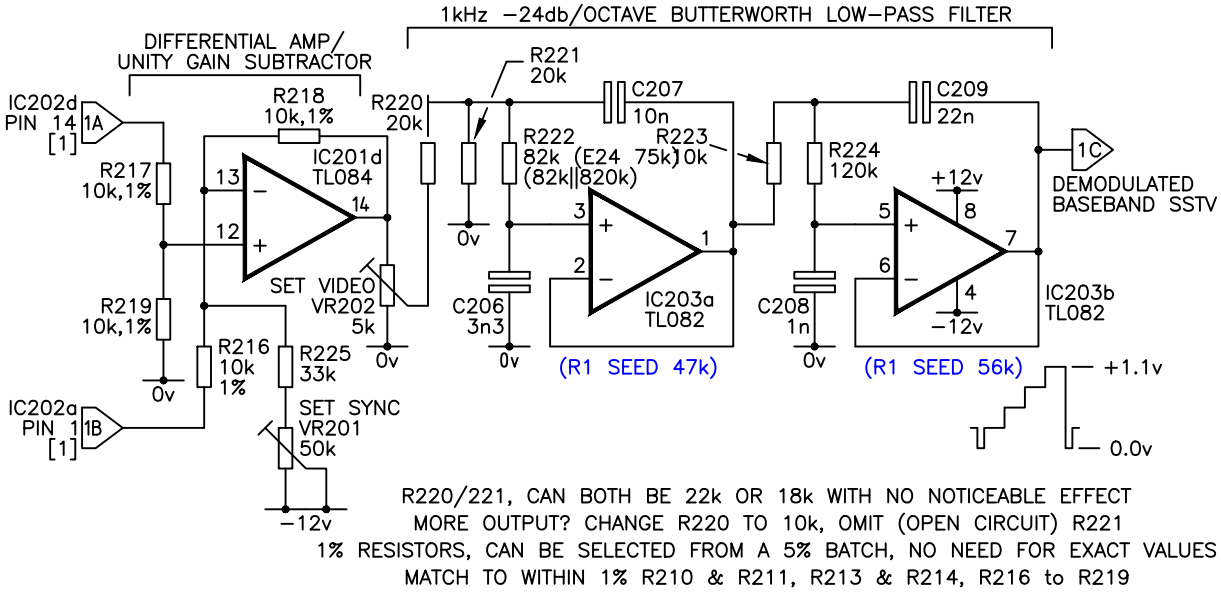

R220/221, CAN BOTH BE 22k OR 18k WITH NO NOTICEABLE EFFECT
MORE OUTPUT? CHANGE R220 TO 10k, OMIT (OPEN CIRCUIT) R221
1% RESISTORS, CAN BE SELECTED FROM A 5% BATCH, NO NEED FOR EXACT VALUES
MATCH TO WITHIN 1% R210 & R211, R213 & R214, R216 to R219

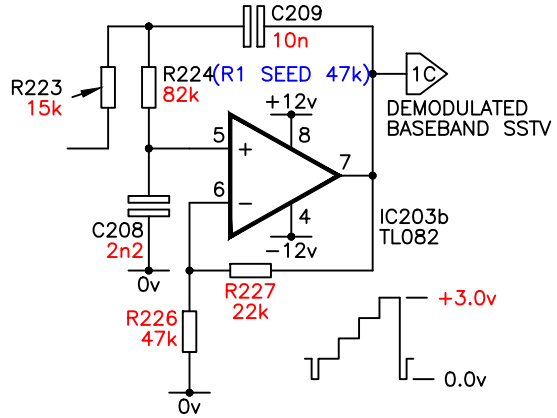

OPTIONAL x1.5 GAIN STAGE SECOND FILTER STAGE
CHANGES/ADDITIONS IN RED
CHANGE R220 TO 10k, OMIT (OPEN CIRCUIT) R221